



GROUND FLOOR PLAN
SCALE: 1:200M

<p>PROJECT OWNER:</p>  <p>SOUTHERN LEYTE STATE UNIVERSITY</p>	<p>PROJECT NAME:</p> <p>AS BUILT PLAN FOR THE COMPLETION OF SLSU MULTI-PURPOSE COURT AND CONSTRUCTION OF GRANDSTAND (LOT-1)</p> <p>ADDRESS: SLSU MAIN CAMPUS, SAN ROQUE, SOGOD, SO. LEYTE</p>	<p>PREPARED BY:</p> <p>PROJECT CONTRACTOR</p>	<p>INSPECTED BY:</p> <p>ENGR. REC ALFONSO P. CINCO MTI, CIVIL ENGINEER</p> <p>ENGR. RYAN A. MACUTO MTI, CIVIL ENGINEER</p> <p>ENGR. MELVIN G. OBUS MTI, ELECTRICAL ENGINEER</p> <p>MR. JOSE V. PALOGOD MTI, ELECTRICAL MAINTENANCE</p> <p>MR. MARIO KUIZON MTI, PLUMBING MAINTENANCE</p>	<p>RECOMMENDING APPROVAL:</p> <p>VP, ADMINISTRATION AND FINANCE</p>	<p>APPROVED BY:</p> <p>UNIVERSITY PRESIDENT</p>	<p>SHEET CONTENT:</p> <p>AS SHOWN</p> <p>ACAD BY: TAJORA, A. CHECKED BY: ENGR. J. CORPIN</p>	<p>SHEET NO.:</p> <p>A 28</p>
---	---	---	--	---	---	--	---

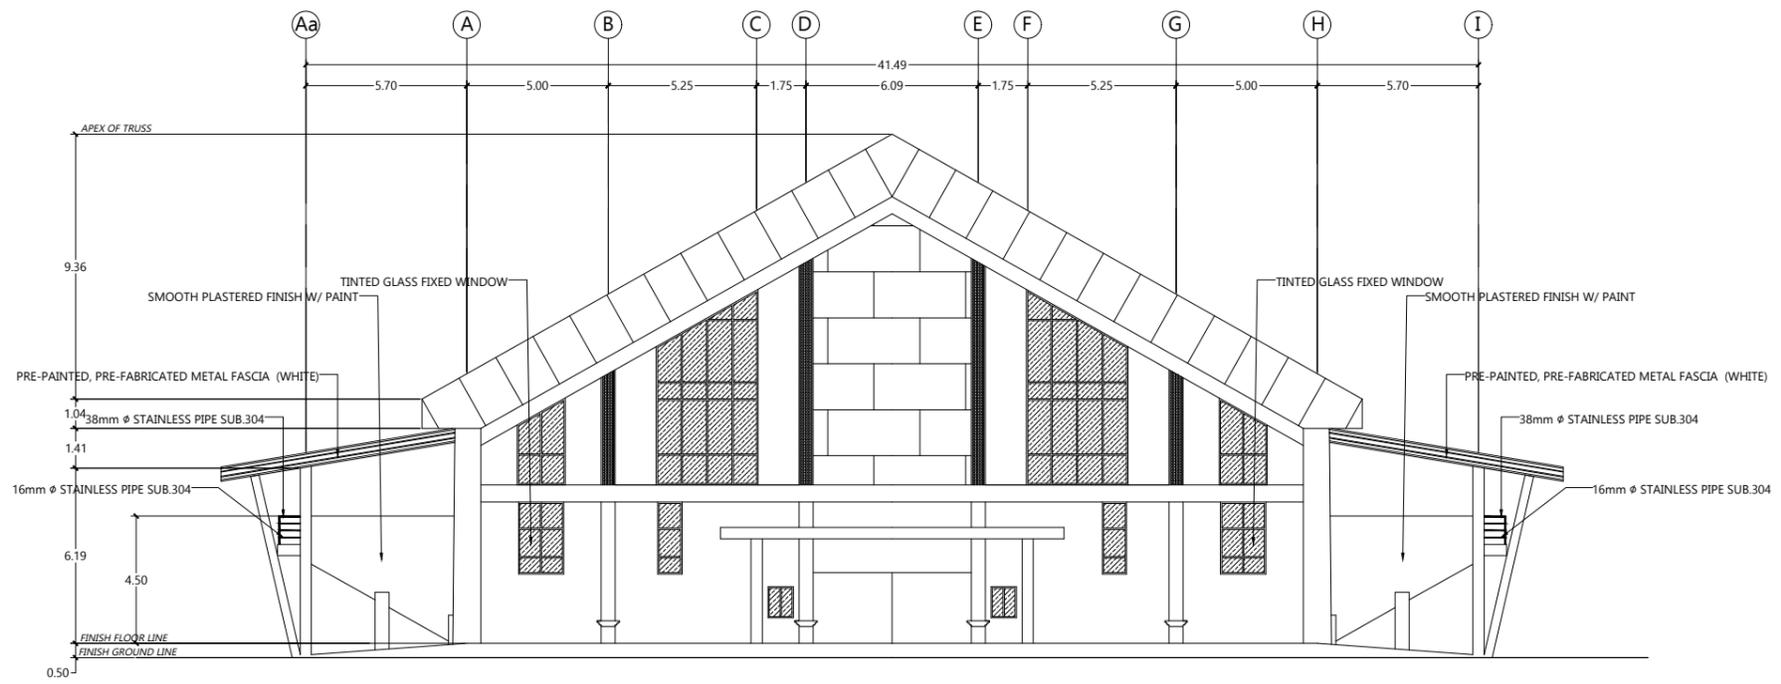

FRONT ELEVATION
SCALE: 1:250M

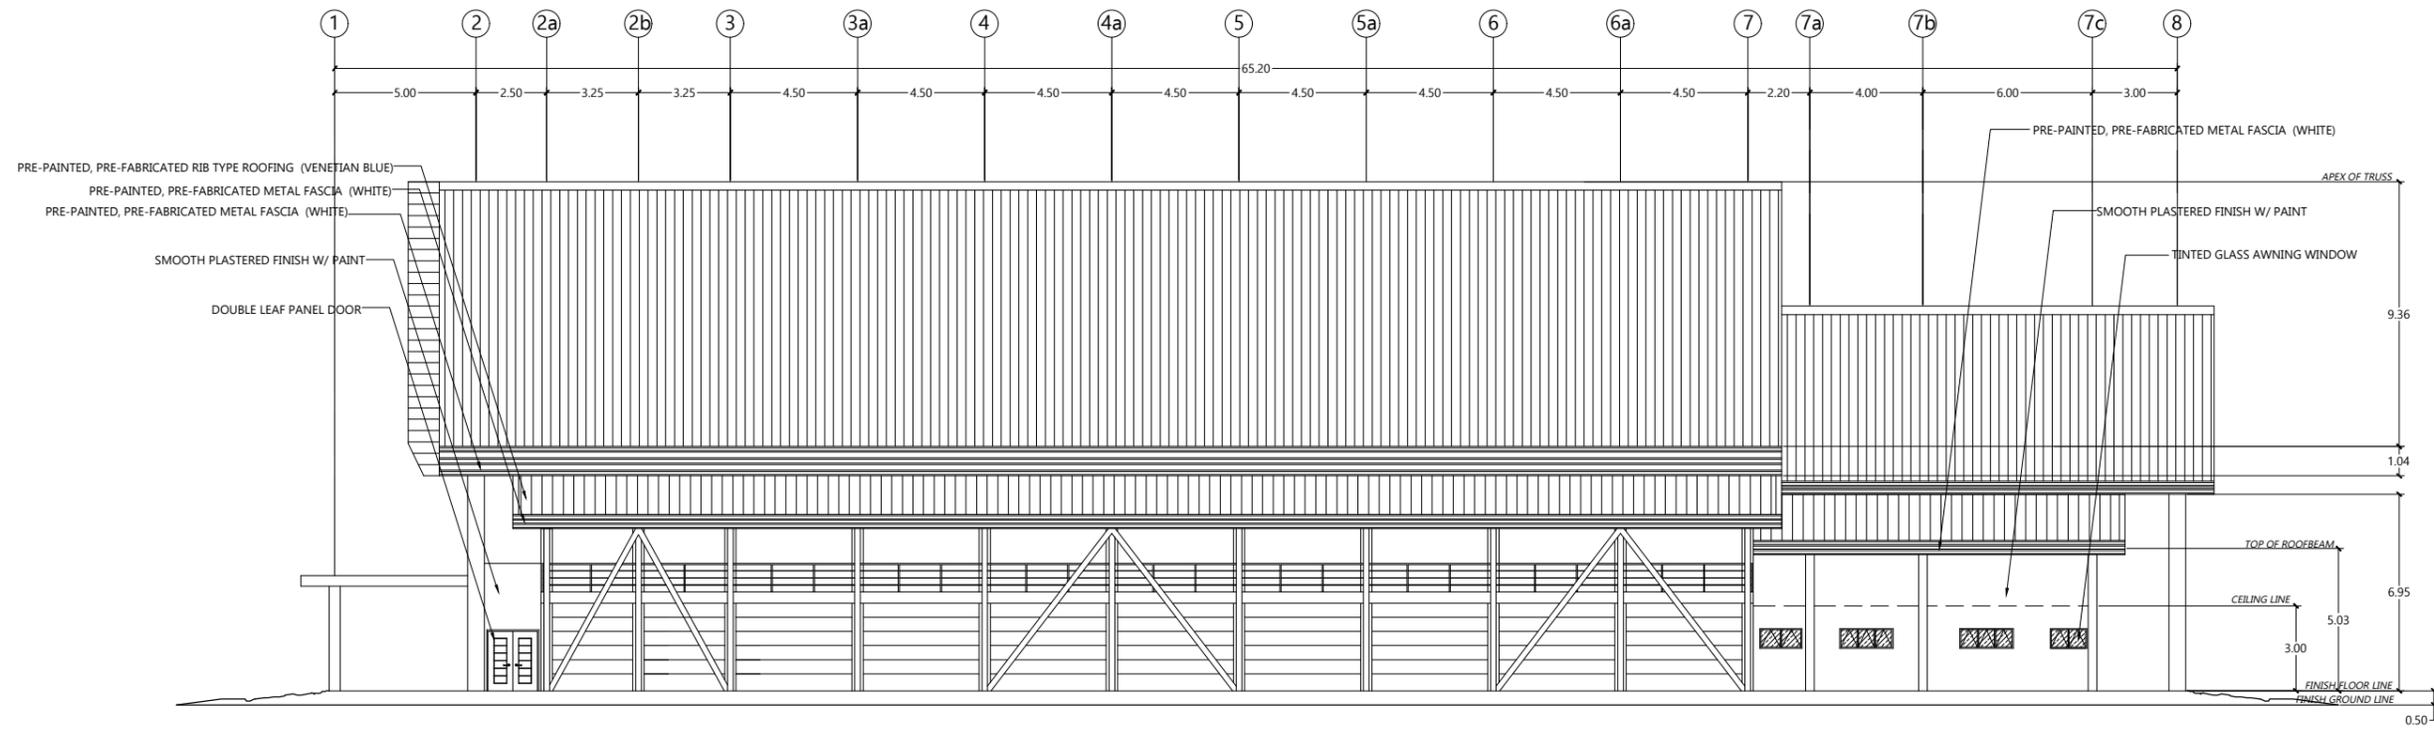

LEFT SIDE ELEVATION
SCALE: 1:250M

PROJECT OWNER:	PROJECT NAME:	PREPARED BY:	INSPECTED BY:	RECOMMENDING APPROVAL:	APPROVED BY:	SHEET CONTENT:	SHEET NO.:
 SOUTHERN LEYTE STATE UNIVERSITY	AS BUILT PLAN FOR THE COMPLETION OF SLSU MULTI-PURPOSE COURT AND CONSTRUCTION OF GRANDSTAND (LOT-1)	 PROJECT CONTRACTOR	ENGR. REC ALFONSO P. CINCO <small>MTI, CIVIL ENGINEER</small> ENGR. RYAN A. MACUTO <small>MTI, CIVIL ENGINEER</small> ENGR. MELVIN G. OBUS <small>MTI, ELECTRICAL ENGINEER</small>	 VP, ADMINISTRATION AND FINANCE	 UNIVERSITY PRESIDENT	AS SHOWN	
	ADDRESS: SLSU MAIN CAMPUS, SAN ROQUE, SOGOD, SO. LEYTE		MR. JOSE V. PALOGOD <small>MTI, ELECTRICAL MAINTENANCE</small> MR. MARIO KUIZON <small>MTI, PLUMBING MAINTENANCE</small>				